



Iroko timber slatted bench with backrest and armrests

4
8004
Proposed Bench (Spec Ref. BE1)




HMV bollard - 1000mm height above ground. 1500x195x183mm

5
8004
Proposed Bollard (Spec Ref. BL1)




Cycle stand - stainless steel - 1000x80mm (760mm above ground level)


6
8004
Cycle Stand (Spec Ref. CS1)

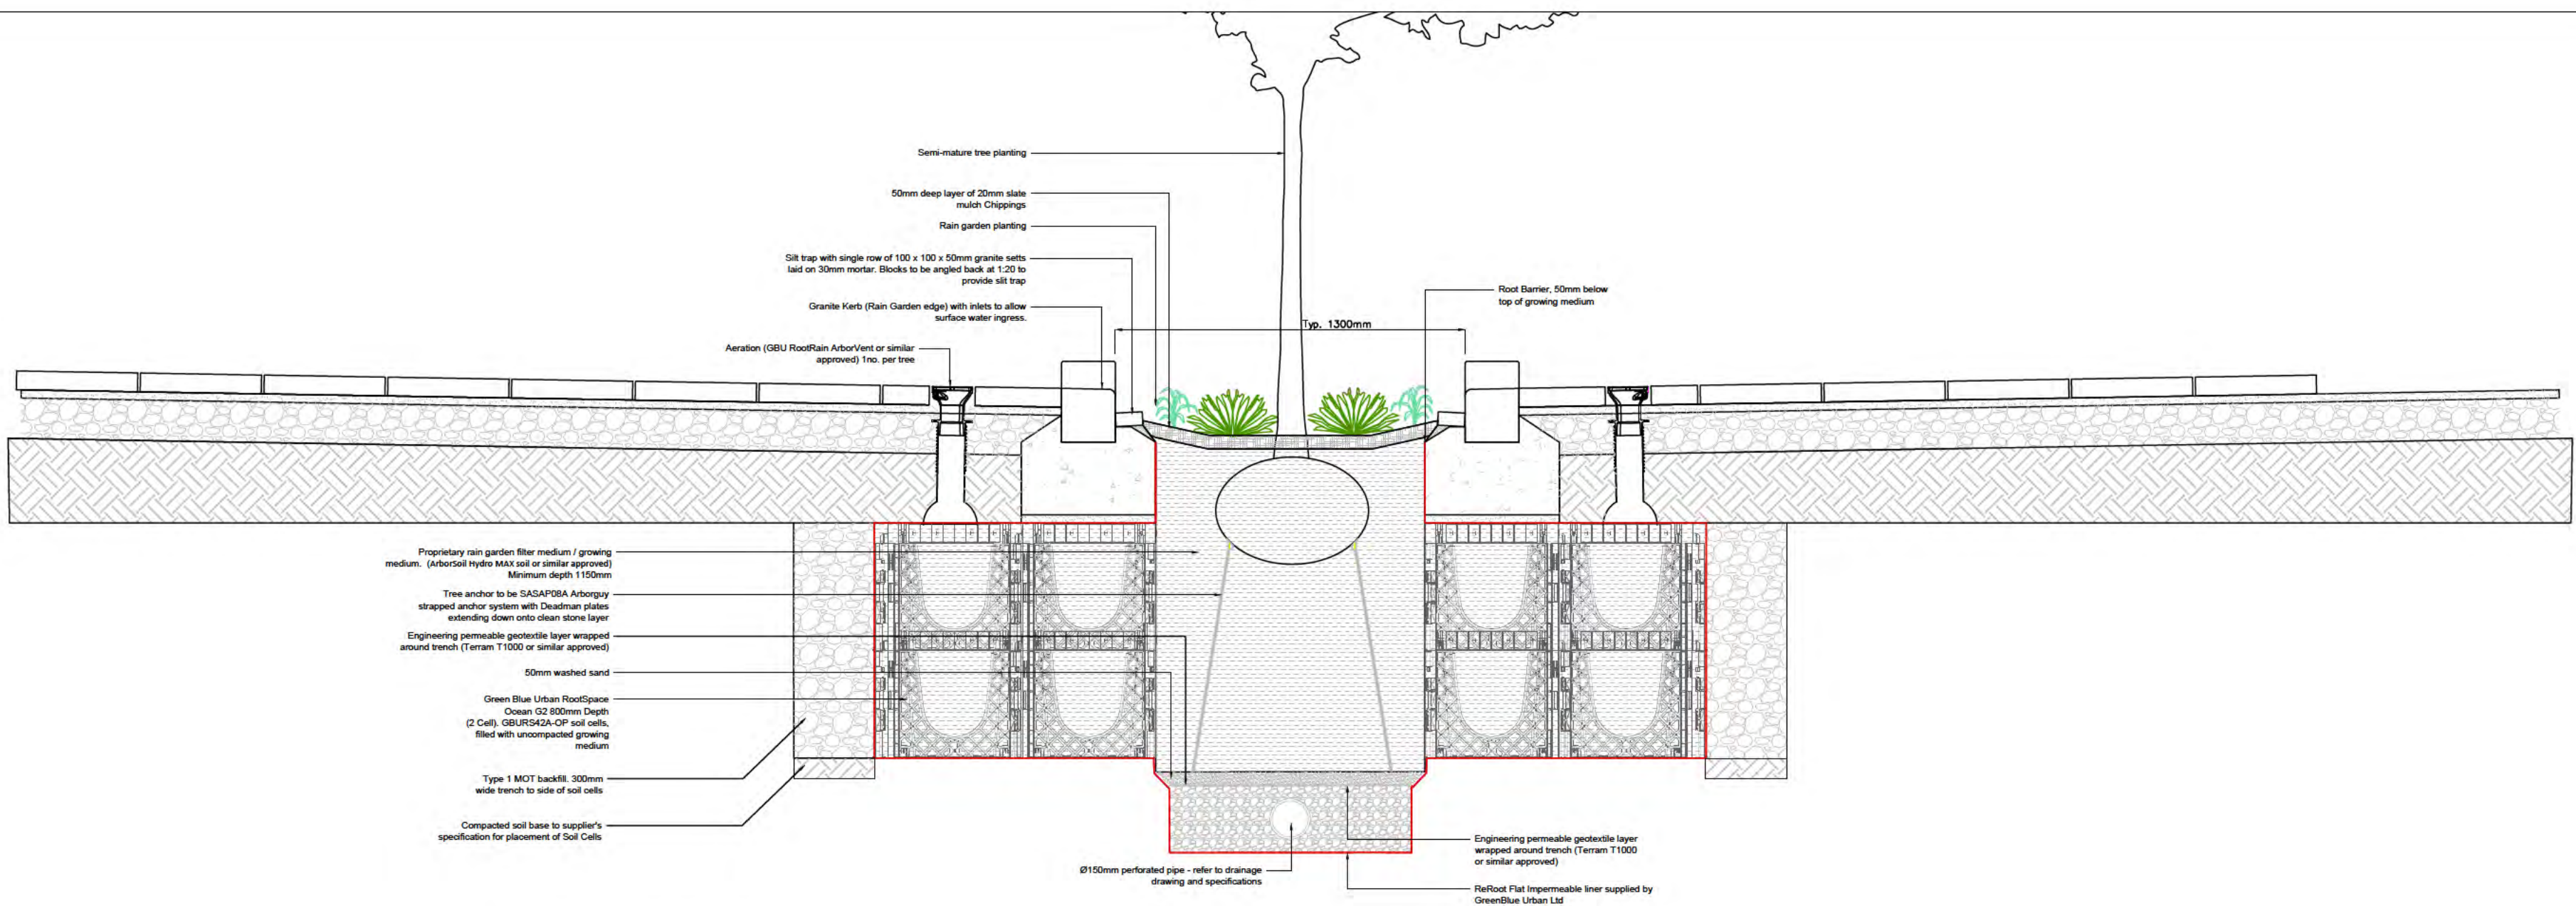

1
8004
Rain Garden - Typical detail through tree pit
1:20

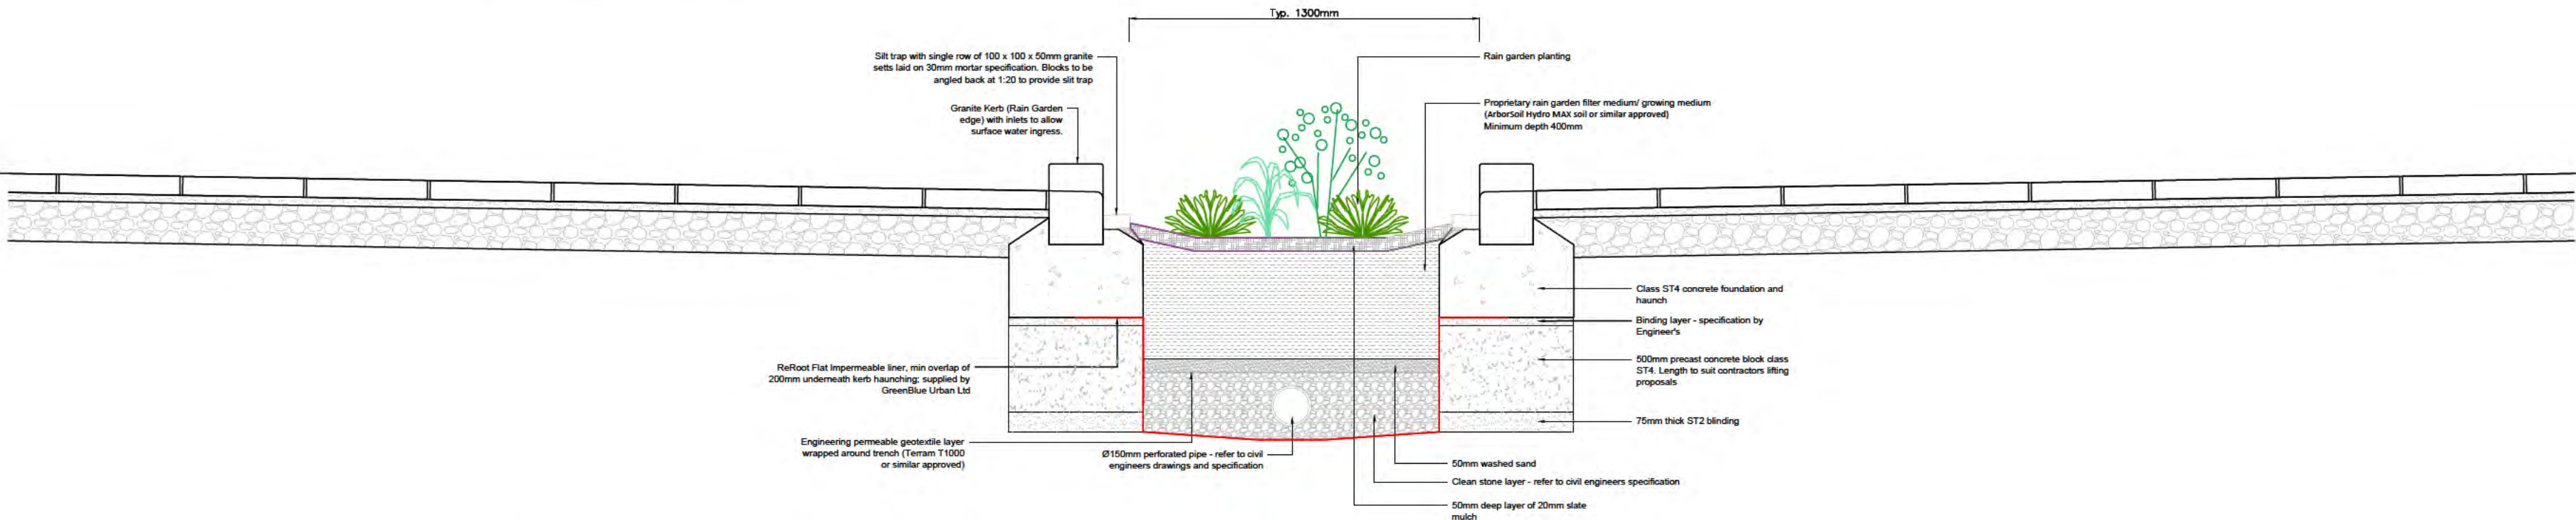

2
8004
Rain Garden - Typical detail through rain garden
1:20

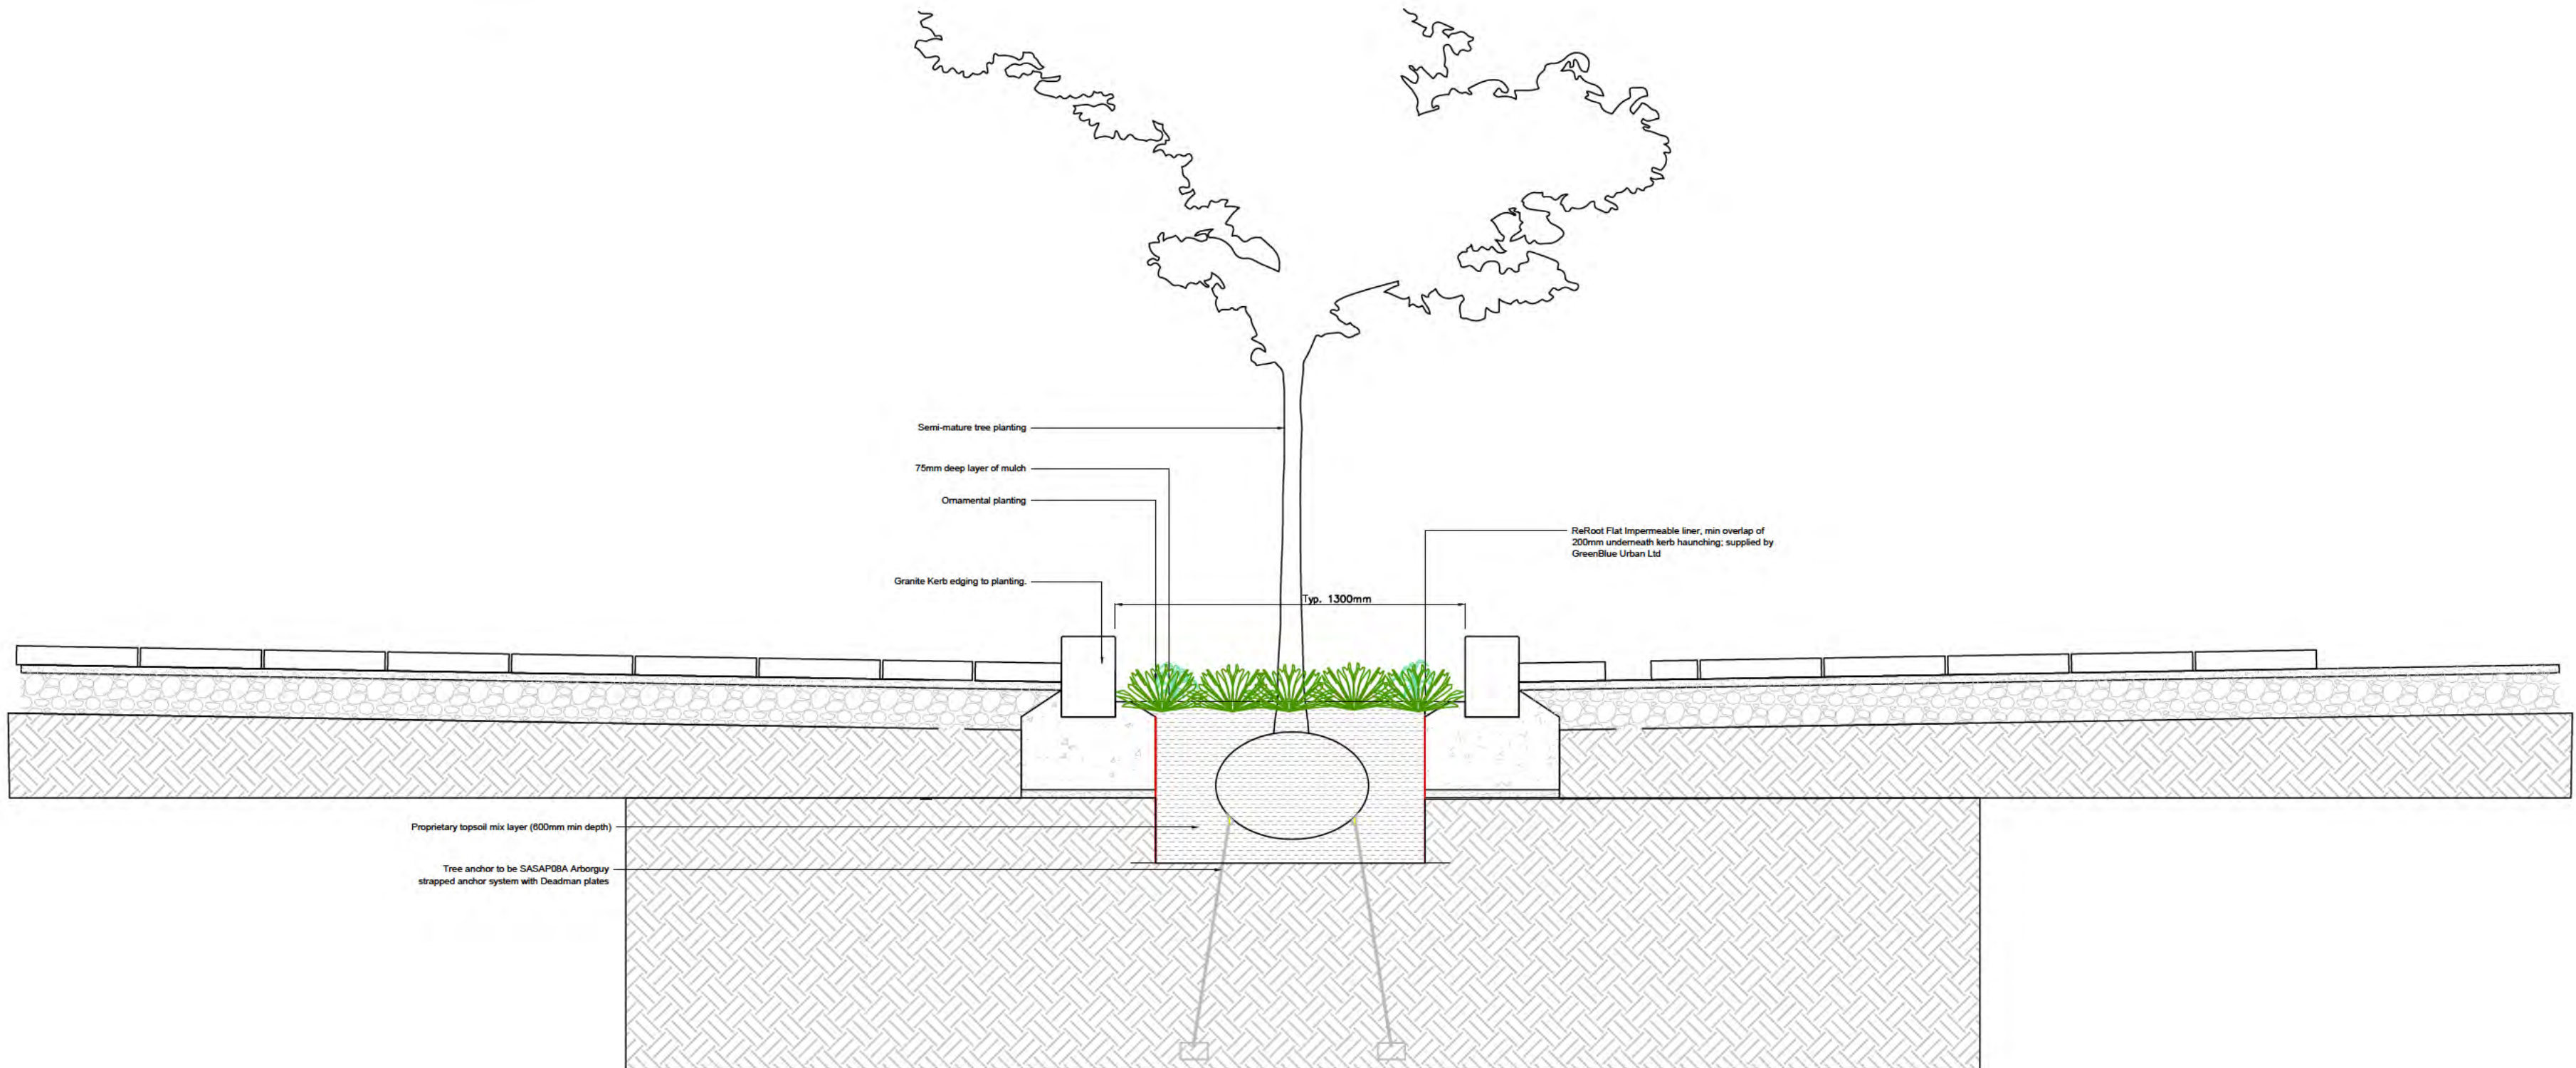

2
8004
Ornamental Planting - Typical detail through tree pit
1:20

Do not scale from this drawing.

• EDINBURGH •
THE CITY OF EDINBURGH COUNCIL

SFN
Sacyr • Farrans • Neopul

SAFETY HEALTH AND ENVIRONMENTAL INFORMATION

REFER TO CDM HAZARD REGISTER DOCUMENT ETYN-SFN-XXX-XX-HS-Z-0001

FOR INFORMATION RELATING TO USE, CLEANING AND MAINTENANCE SEE THE HEALTH AND SAFETY FILE.

NOTES
1. ALL DIMENSIONS ARE IN MILLIMETRES UNLESS NOTED OTHERWISE.
2. THE LANDSCAPE PROPOSAL DRAWINGS ARE TO BE READ IN CONJUNCTION WITH THE ENGINEERING PACKAGES INCLUDING; ROADWORKS; KERBS; FOOTWAYS AND PAVED AREAS; STRUCTURAL AND WALL DRAWINGS, ROAD MARKINGS; ROAD SIGNS AND SIGNALS; STREET LIGHTING; DRAINAGE WORKS AND TRAM ALIGNMENT. THEY SHOULD ALSO BE READ IN CONJUNCTION WITH THE ACCOMMODATION WORKS PACKAGE.
3. DRAWING TO BE READ IN CONJUNCTION WITH LANDSCAPE HARDWORKS DRAWINGS ETYN-SFN-2XX-04-DR-L-0003.
4. DRAWING TO BE READ IN CONJUNCTION WITH LANDSCAPE SOFTWARES DRAWINGS ETYN-SFN-2XX-04-DR-L-0001 - 0002

C01	05.10.23	CONSTRUCTION RECORDS			
Rev.	Date	CONSTRUCTION RECORDS	Exec.	Chkd.	Appd.

Project Title: EDINBURGH TRAM
YORK PLACE TO NEWHAVEN

Drawing Title: LANDSCAPE PROPOSALS
PICARDY PLACE
LANDSCAPE DETAIL

Scale: 1:10	AS SHOWN	AS-BUILT
Drawn: [initials]	Checked: [initials]	Approved: [initials]
Date: 19/01/23	Date: 01/03/23	Date: 01/03/23

Project	Originator	Volume	Location	Type	Role	Number
ETYN-SFN-2XX-04-DR-L-0004						

Availability: [initials]	Revision: C01
--------------------------	---------------