



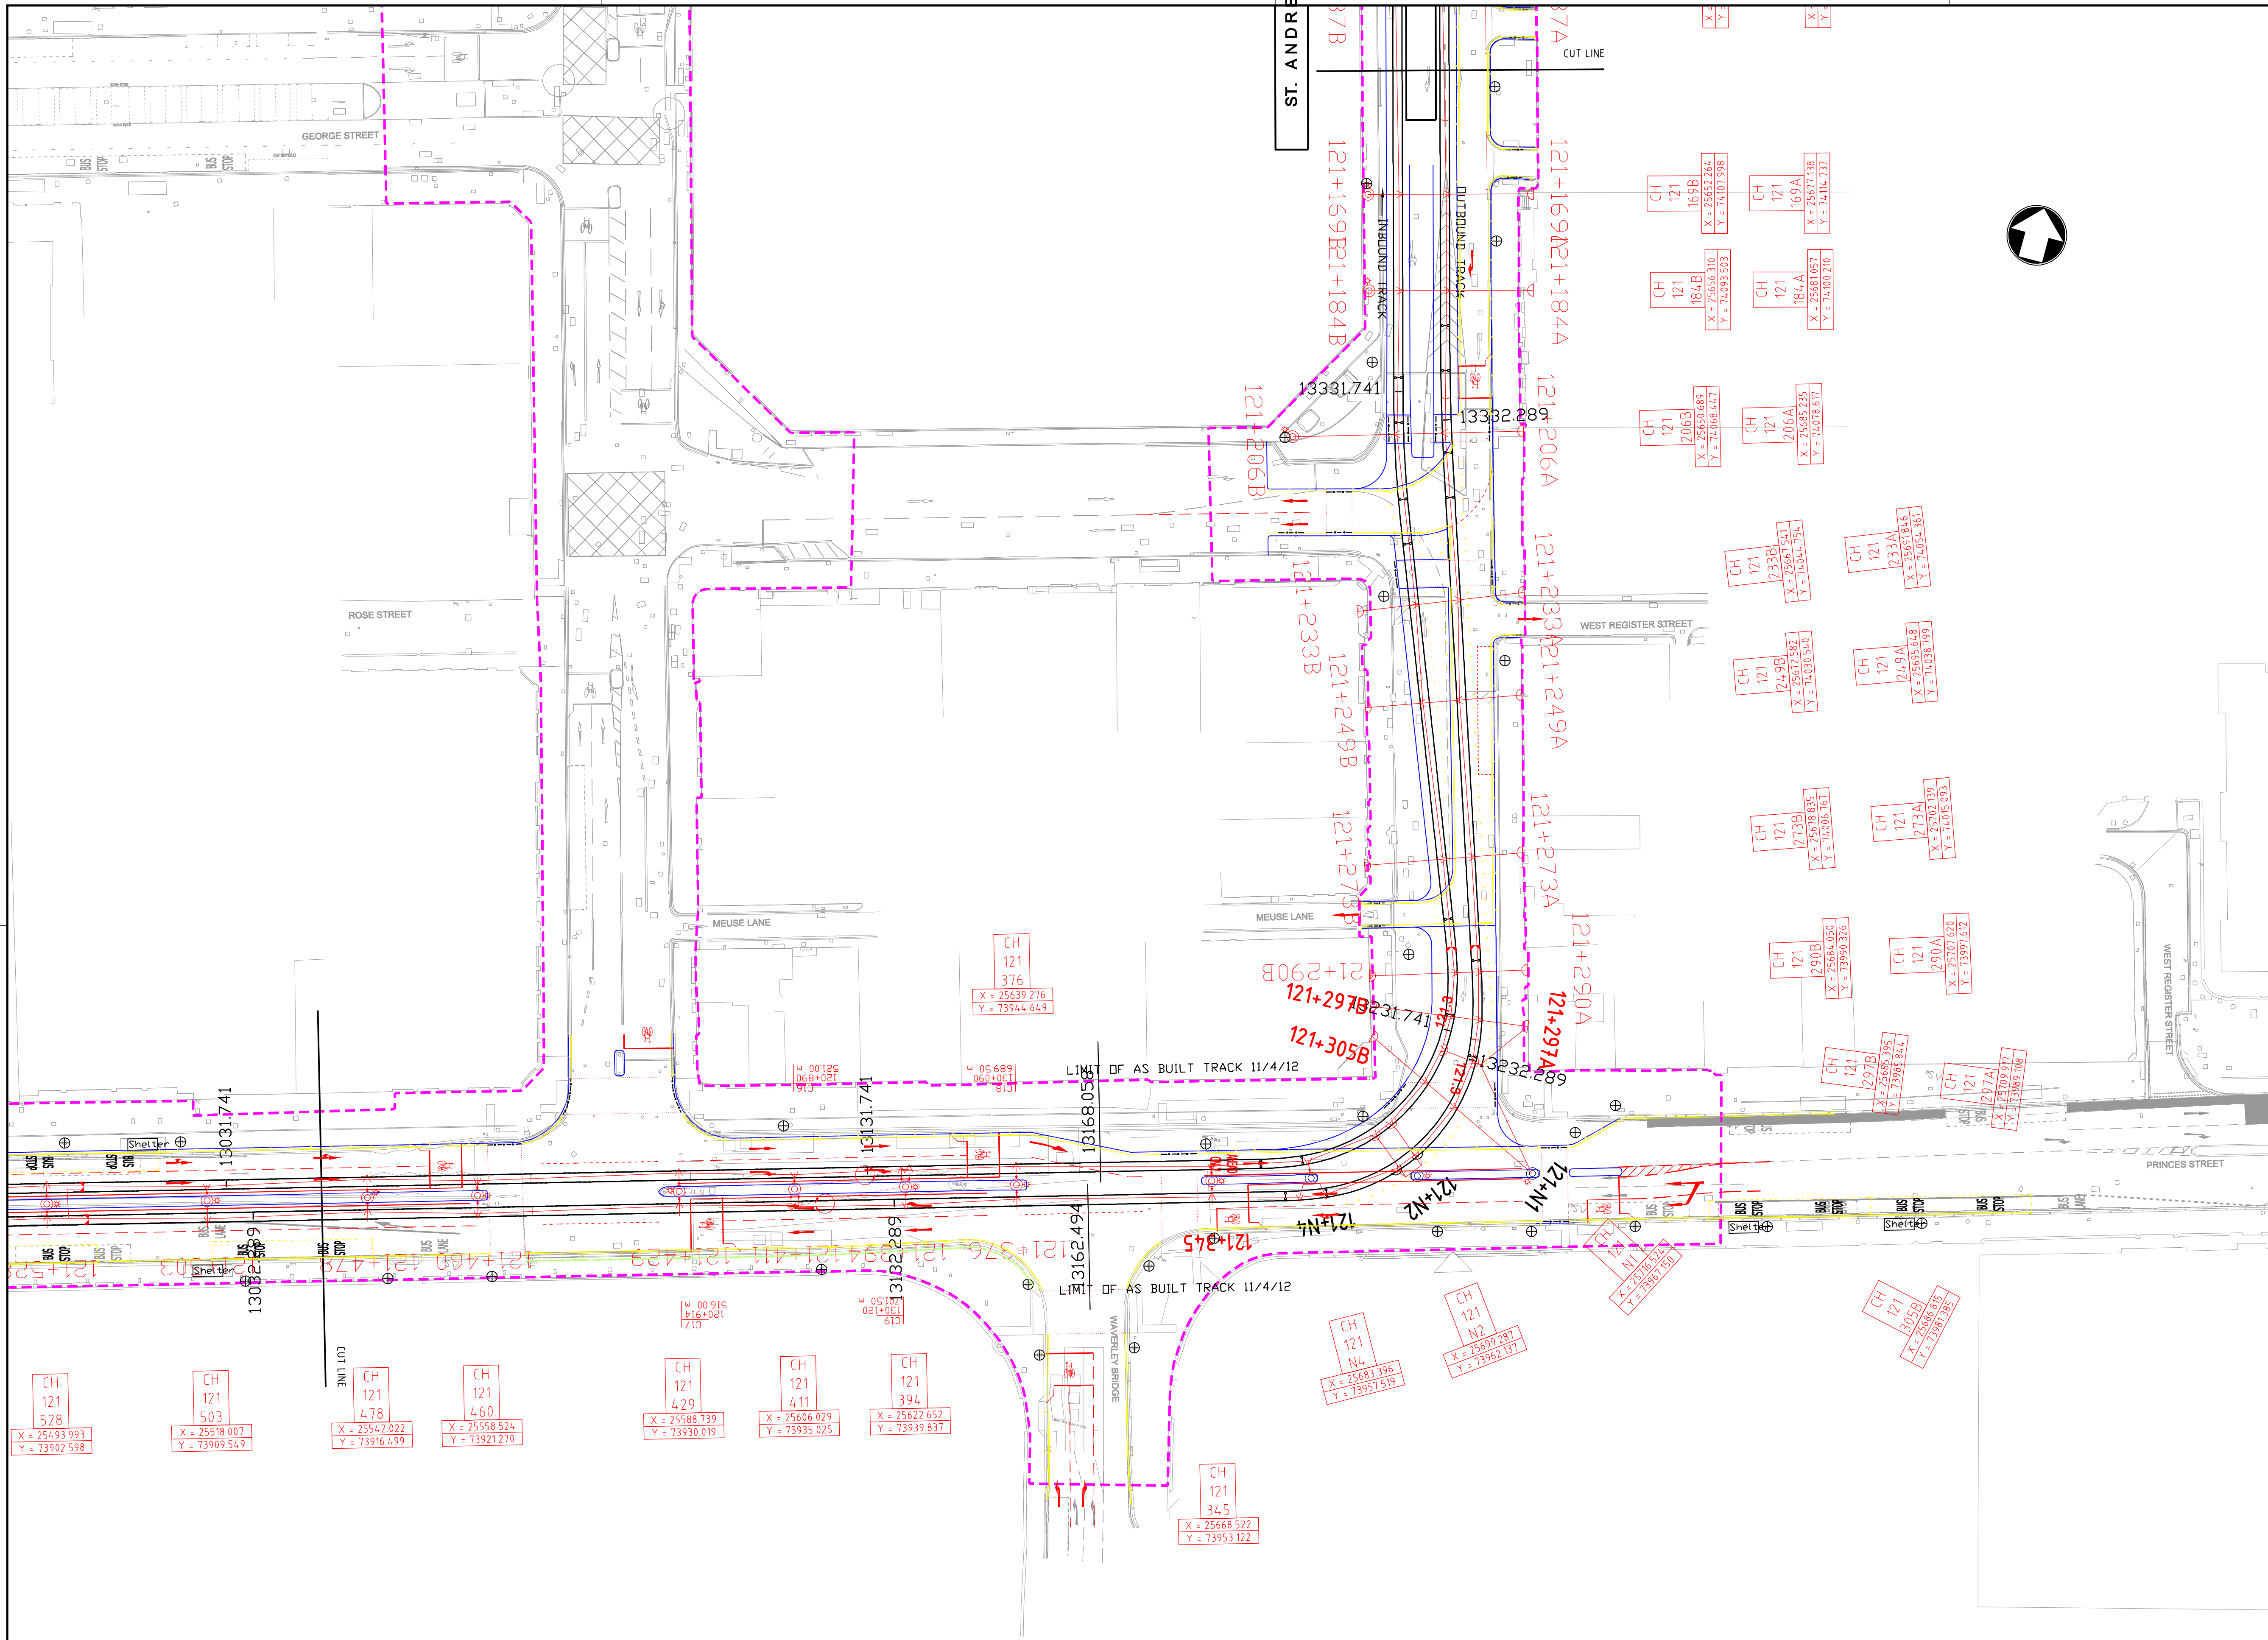

NOTES
1 THIS DRAWING IS FOR THE PURPOSE OF POSITIONING THE OLE POLE AND BACK-TIE BASES ONLY, AND NOT FOR THE INSTALLATION OF THE SYSTEM DESIGN

KEY

- LIMIT OF DEVIATION
- ⊙ AGREED OLE POLE POSITION
- TRACK

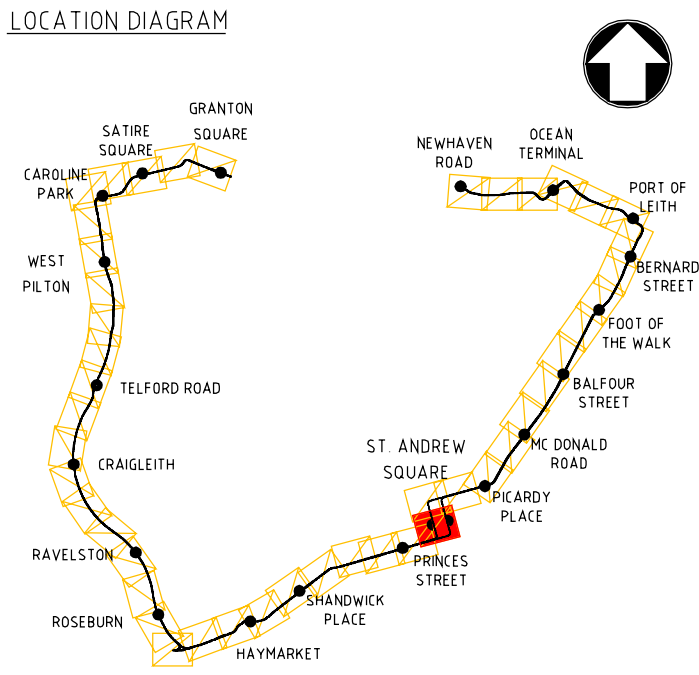

4	AS BUILT	ST	GL	GL	04/03/14
REV	DESCRIPTION OF REVISION	DRN	CHKD	APP	DATE

DRAWING STATUS



EDINBURGH TRAM NETWORK

505 CITY POINT
65 HAYMARKET TERRACE
EDINBURGH EH12 5HD

NEWHAVEN ROAD TO HAYMARKET
OUTLINE OLE LAYOUT PLAN
POLE REALIGNMENT FOR SECTION 1
SHEET 18 OF 24

DRAWN BY	CROMARC	CHECKED BY	POPEC
APPROVED BY	DOLANA	ORIGINAL DRAWING SIZE	A1
DATE	09/07/2009	SCALE(S)	1500
DRAWING NUMBER	ULE90130-01-DRG-00788	REV	4