


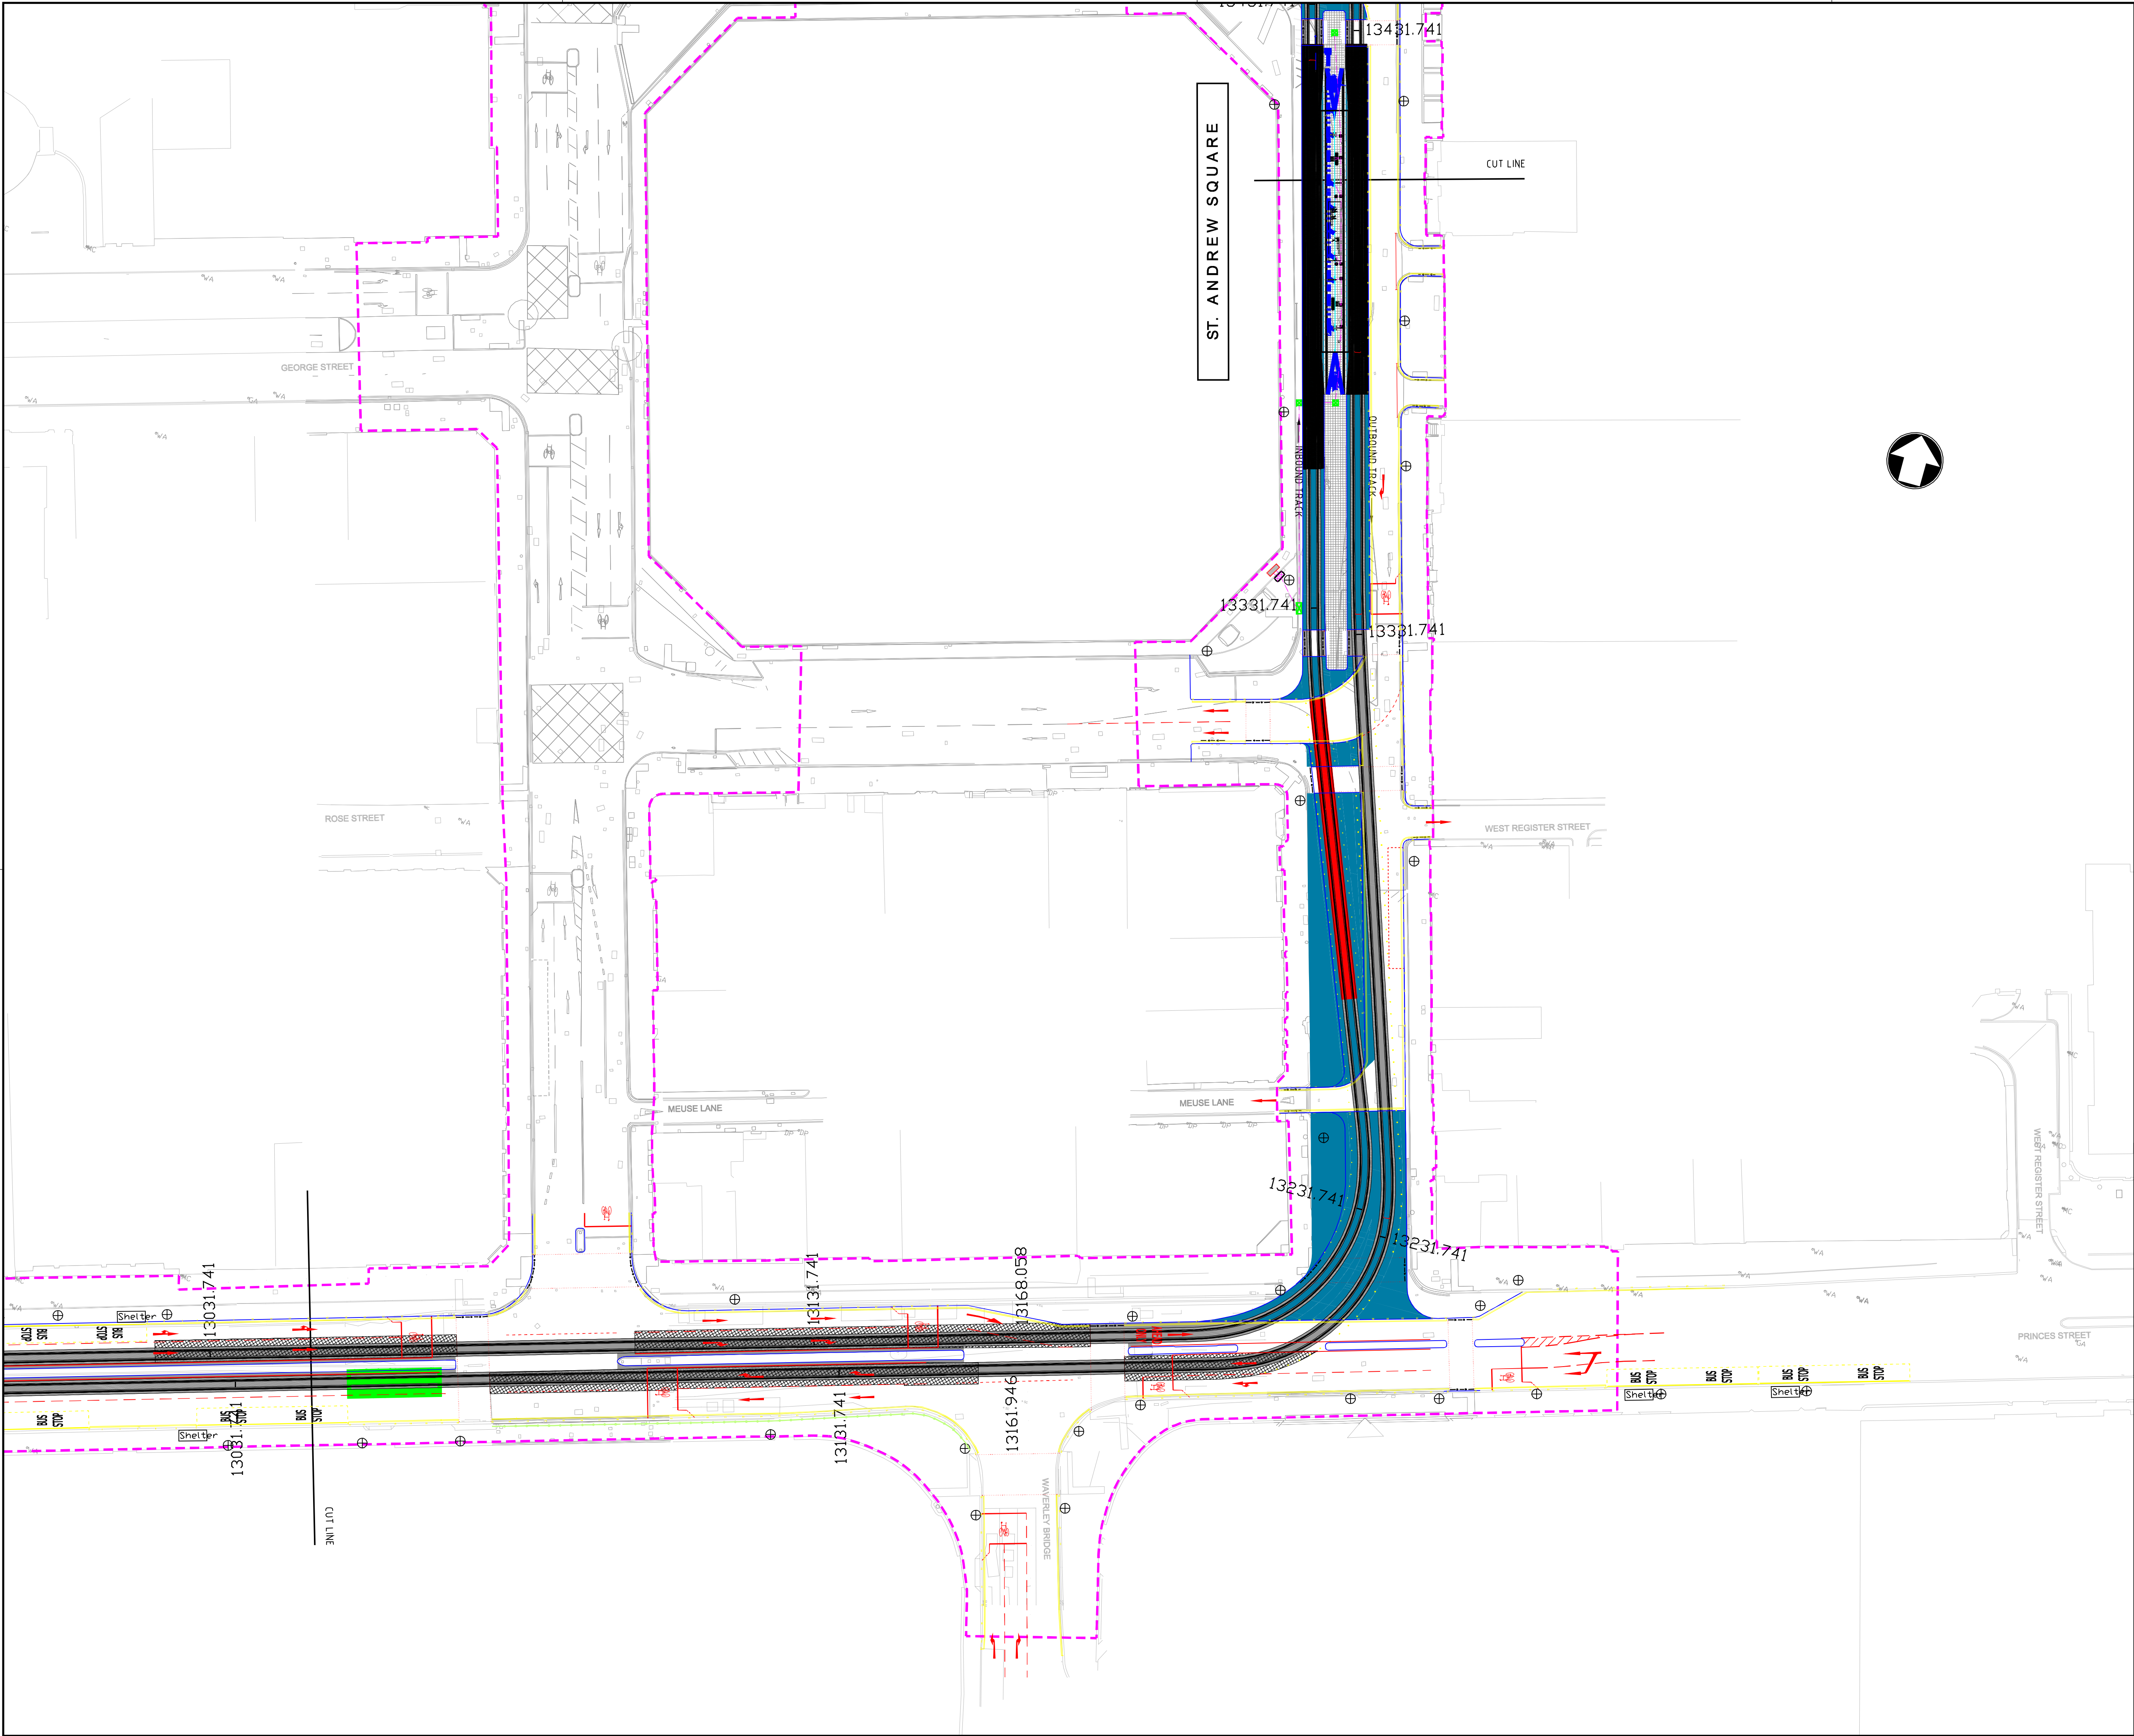

- NOTES
1. THIS DRAWING REPRESENTS THE AREA OF TRACKFORM ONLY. TO SHOW THE MATERIAL AND TREATMENT FINISHES APPLIED TO THE ROAD SURFACE AT TRACKFORM AREA. FOR ALL OTHER ROAD PAVEMENT DETAILS INCLUDING CYCLE MARKINGS REFER TO ULE90130-01-HRL-SERIES.
 2. FOR PAVEMENT DETAILS REFER TO ULE90130-01-HRL-SERIES.
 3. FOR KERB DETAILS REFER TO ULE90130-01-HRL-01100 SERIES.
 4. FOR ROAD CONSTRUCTION DETAILS REFER TO APPENDIX 7/1.
 5. FOR SURFACE FINISHES REFER TO APPENDIX 11/1 AND ULE90130-01-HRL-012XX SERIES.
 6. FOR CONCRETE TRACKFORM DETAILS REFER TO ULE90130-01-DRG-00992 TO 00994, 00996 TO 00998 & 01003 WHERE RELEVANT.
 7. FOR RHEDA CITY-C TRACKFORM DETAILS REFER TO ETNITRW=TD&ATB#055716.
 8. FOR RHEDA CITY-D TRACKFORM DETAILS REFER TO ETNITRW=TD&ATB#055717.
 9. FOR TRAM ONLY AND TRAM & BUS ONLY SURFACING REFER TO APPENDIX 7/1 SCHEDULES.
 10. FOR DETAILS AT TRAMSTOPS REFER TO STP SERIES OF DRAWINGS AND APPENDIX 11/1.
 11. TRACKFORM CHANGES HAVE BEEN TAKEN FROM BSC TRACKFORM OVERVIEW ETNIBSCITIE&ABC #057156 REVISION H.

KEY

	LIMIT OF DEVIATION
	LIMIT OF LAND ACQUIRED OR USED (LLAU)
	KERBLINE
	CONCRETE TO AGREED SPECIFICATION WITH BLACK COLOURED PIGMENTATION
	SETTS
	IMPRINTED FOR STREET
	TRAM ONLY SURFACING
	TRAM & BUS ONLY
	HIGH FRICTION SURFACING - BLACK COLOUR
	CONCRETE TO AGREED SPECIFICATION WITH NO COLOUR PIGMENTATION

8	AS BUILT	JK	GL	GL	29/01/14
REV	DESCRIPTION OF REVISION	DRN	CHKD	APP	DATE

DRAWING STATUS

As Built

EDINBURGH TRAM NETWORK

PARSONS BRINCKERHOFF

SQS
CITY POINT
65 HAYMARKET TERRACE
EDINBURGH EH12 5HD

NEWHAVEN ROAD TO HAYMARKET
TRACKFORM PLANS
SHEET 18 OF 25
SECTION 1C

DRAWN BY	STACHOWIAK J	CHECKED BY	REIDCH
APPROVED BY	DOLANA	ORIGINAL DRAWING SIZE	A1
DATE	28/04/2011	SCALE(S)	1:500 @ A1
DRAWING NUMBER	ULE90130-01-DRG-00981		REV
			8

PB INTERNAL VERSION NUMBER: 8