



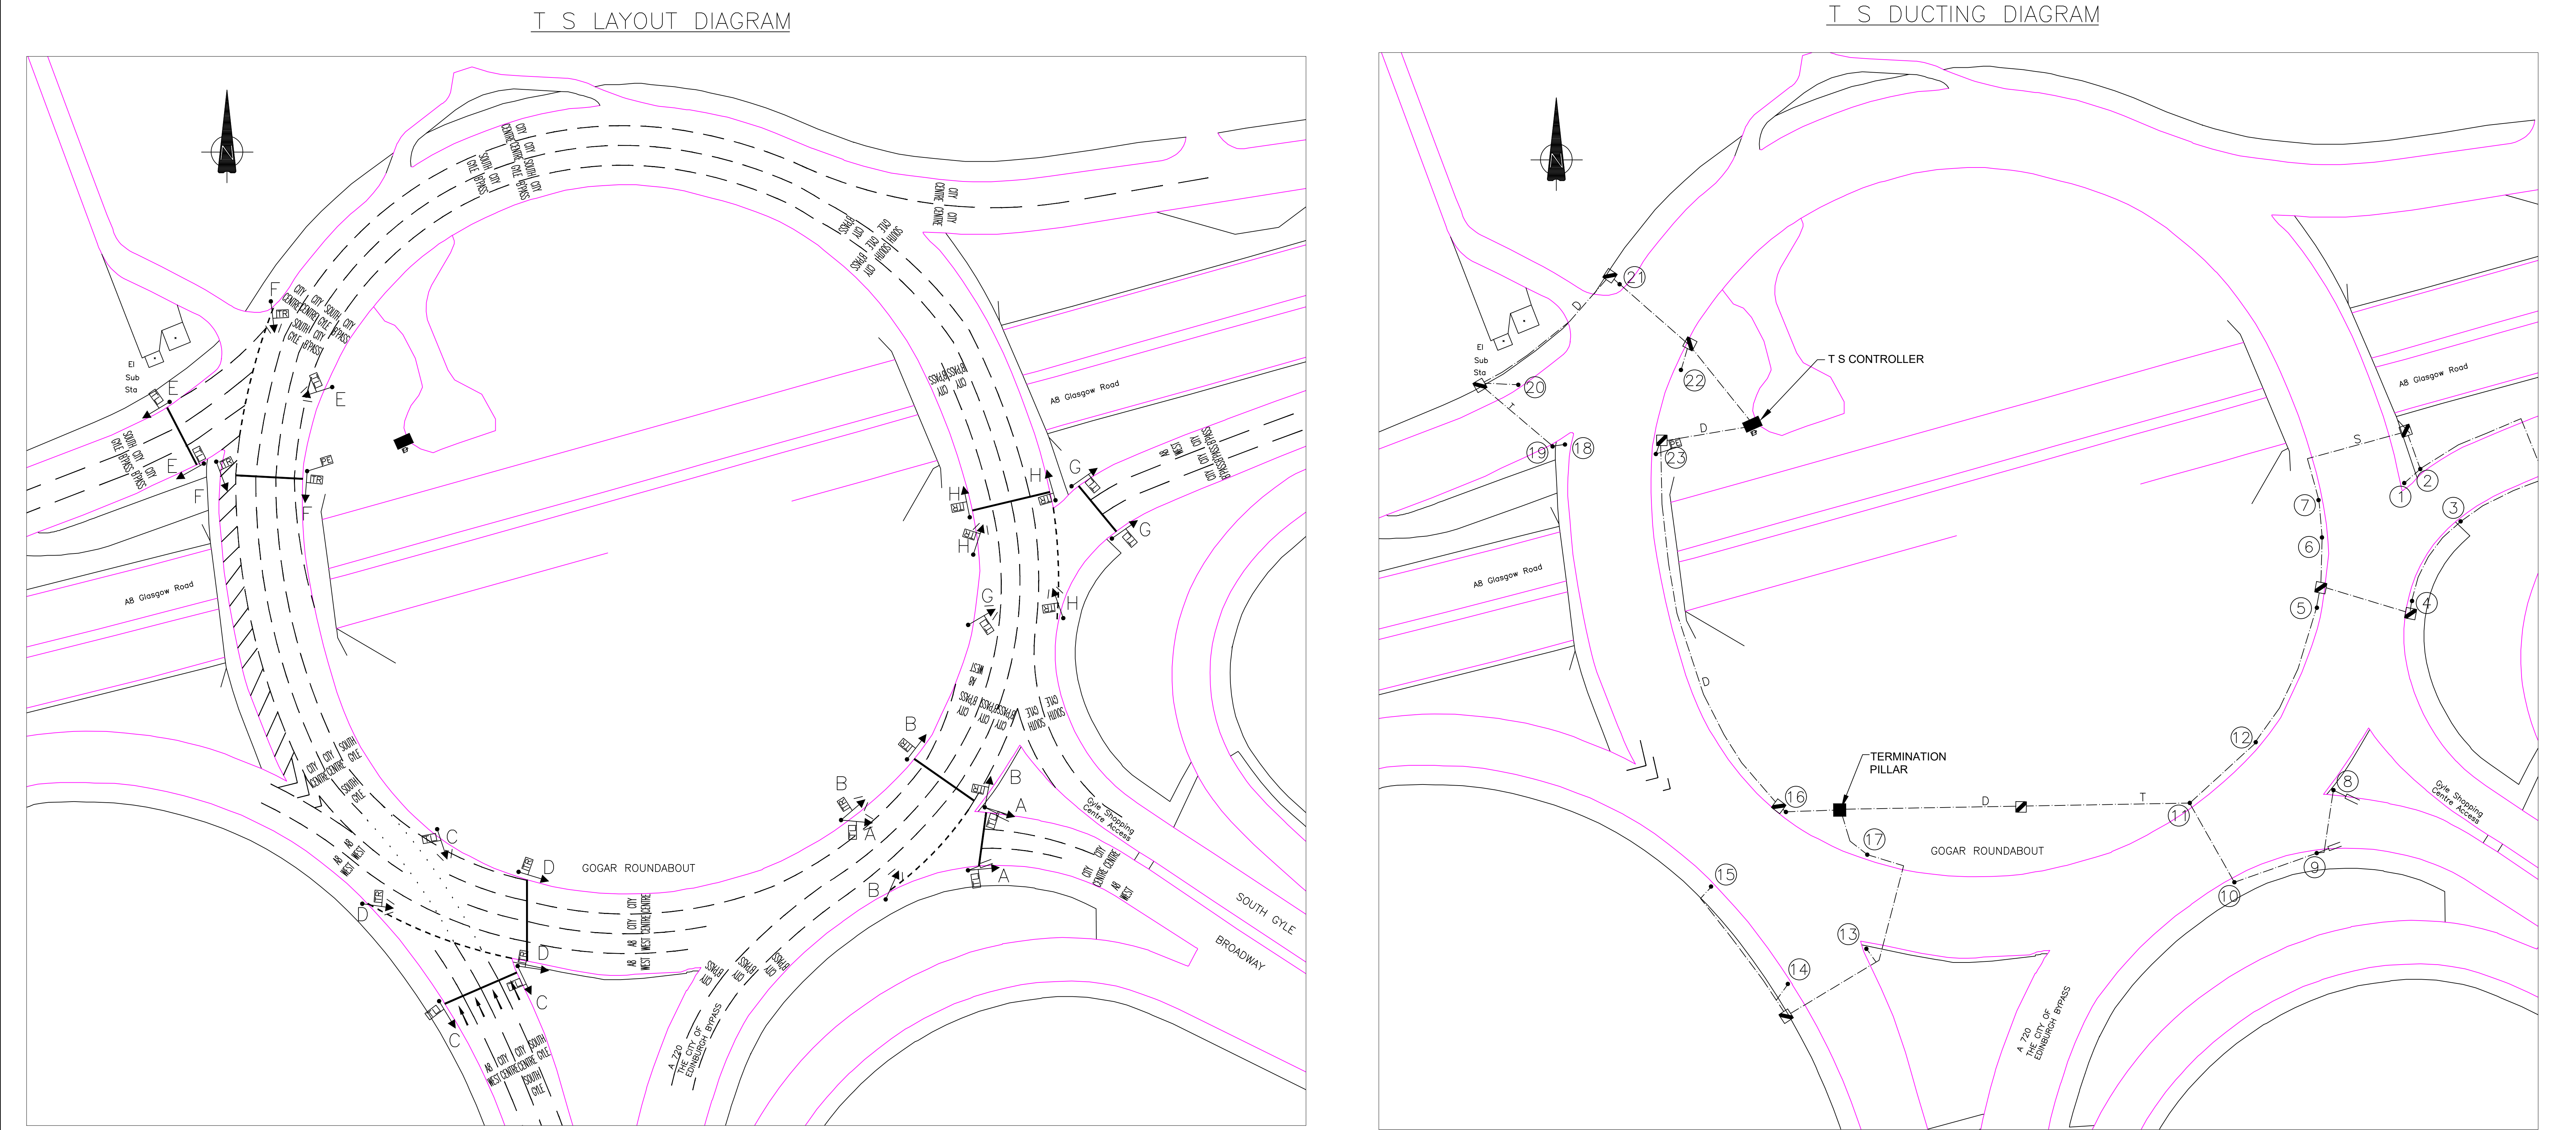

NOTES:

From	To	Cable
Cont	P21	20 Core
P21	P20	20 Core
P20	P19	20 Core
P19	P18	20 core
Cont	P23	20 Core
P23	P22	20 Core
Cont	P20	8 core
P20	P19	8 core
P19	P18	8 core
Cont	P23	8 core
Cont	P21	20c Spare
Cont	TP	20 Core
TP	P4	20 Core
P4	P3	20 Core
P3	P1	20 Core
P1	P7	20 Core
P7	P6	20 Core
P6	P5	20 Core
Cont	TP	20 Core
TP	P11	20 Core
P11	P12	20 Core
P12	P8	20 Core
P8	P9	20 Core
P9	P10	20 Core
Cont	TP	8 core
TP	P9	8 core
P9	P8	8 core
Cont	TP	20 core
TP	P16	20 Core
P16	P17	20 Core
P17	P13	20 Core
P13	P14	20 Core
P14	P15	20 Core

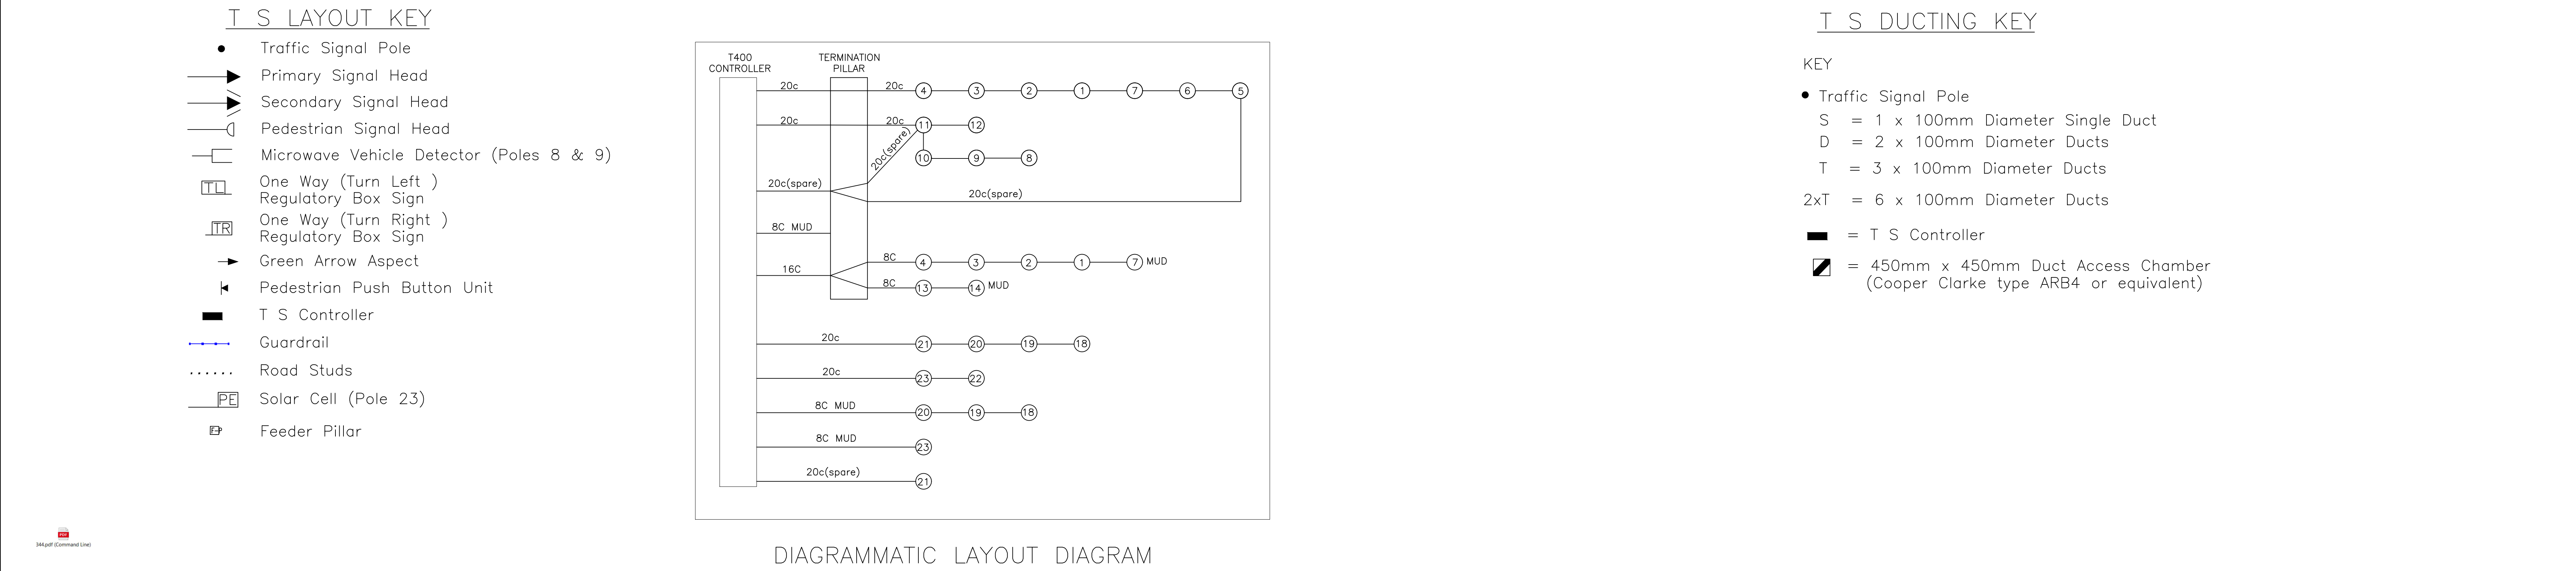

REVISION	DETAILS	BY	DATE	CHECKED
F	Added feeder pillar		SR 11/05/26	
E	Updated the cable table		SR 30/07/24	
D	Turn Right Sign added to p6		SR 27/05/24	
C	As built (SIEMENS)		SO'N 2.06.15	
B	As built Traffic Signals		PG 270704	
A	CHANGED DWG. NO.		SR 1/10/2002	

